

PRODUCT:

MATERIAL: WOVEN GLASS/CARBON FIBER ARAMIDS
WIDTH: 63" MAXIMUM

UTILITIES:

ELECTRIC POWER: 480 VAC, 3 PHASE, 60 Hz
ELECTRIC CONTROL: 24 VDC

COMPRESSED AIR: 80 PSI, CLEAN, DRY

CODE:

INSURANCE CODE: FM GLOBAL
OVEN CODE: NFPA 86
ELECTRICAL CODE: NEC
STEEL CODE: AISC
SAFETY CODE: OSHA, ASME
SEISMIC CODE: IBC

MACHINE:


LINE SPEED: 5-30 FPM

TENSIONS: 1.0 PLI TO 2.5 PLI

NIP ROLLS: ROLL DIA.: UPPER Ø5 1/2" WITH 9/16" HYPALON 75 SHORE A DUROMETER
LOWER Ø5 1/2" WITH STEEL CHROME PLATED
ROLL FACE: 67"

IDLER ROLLS: ROLL DIA.: Ø4" ANODIZED ALUMINUM
ROLL FACE: 67"

STORAGE: 26 SECONDS @ 23 FPM (MORE AT LOWER SPEEDS)

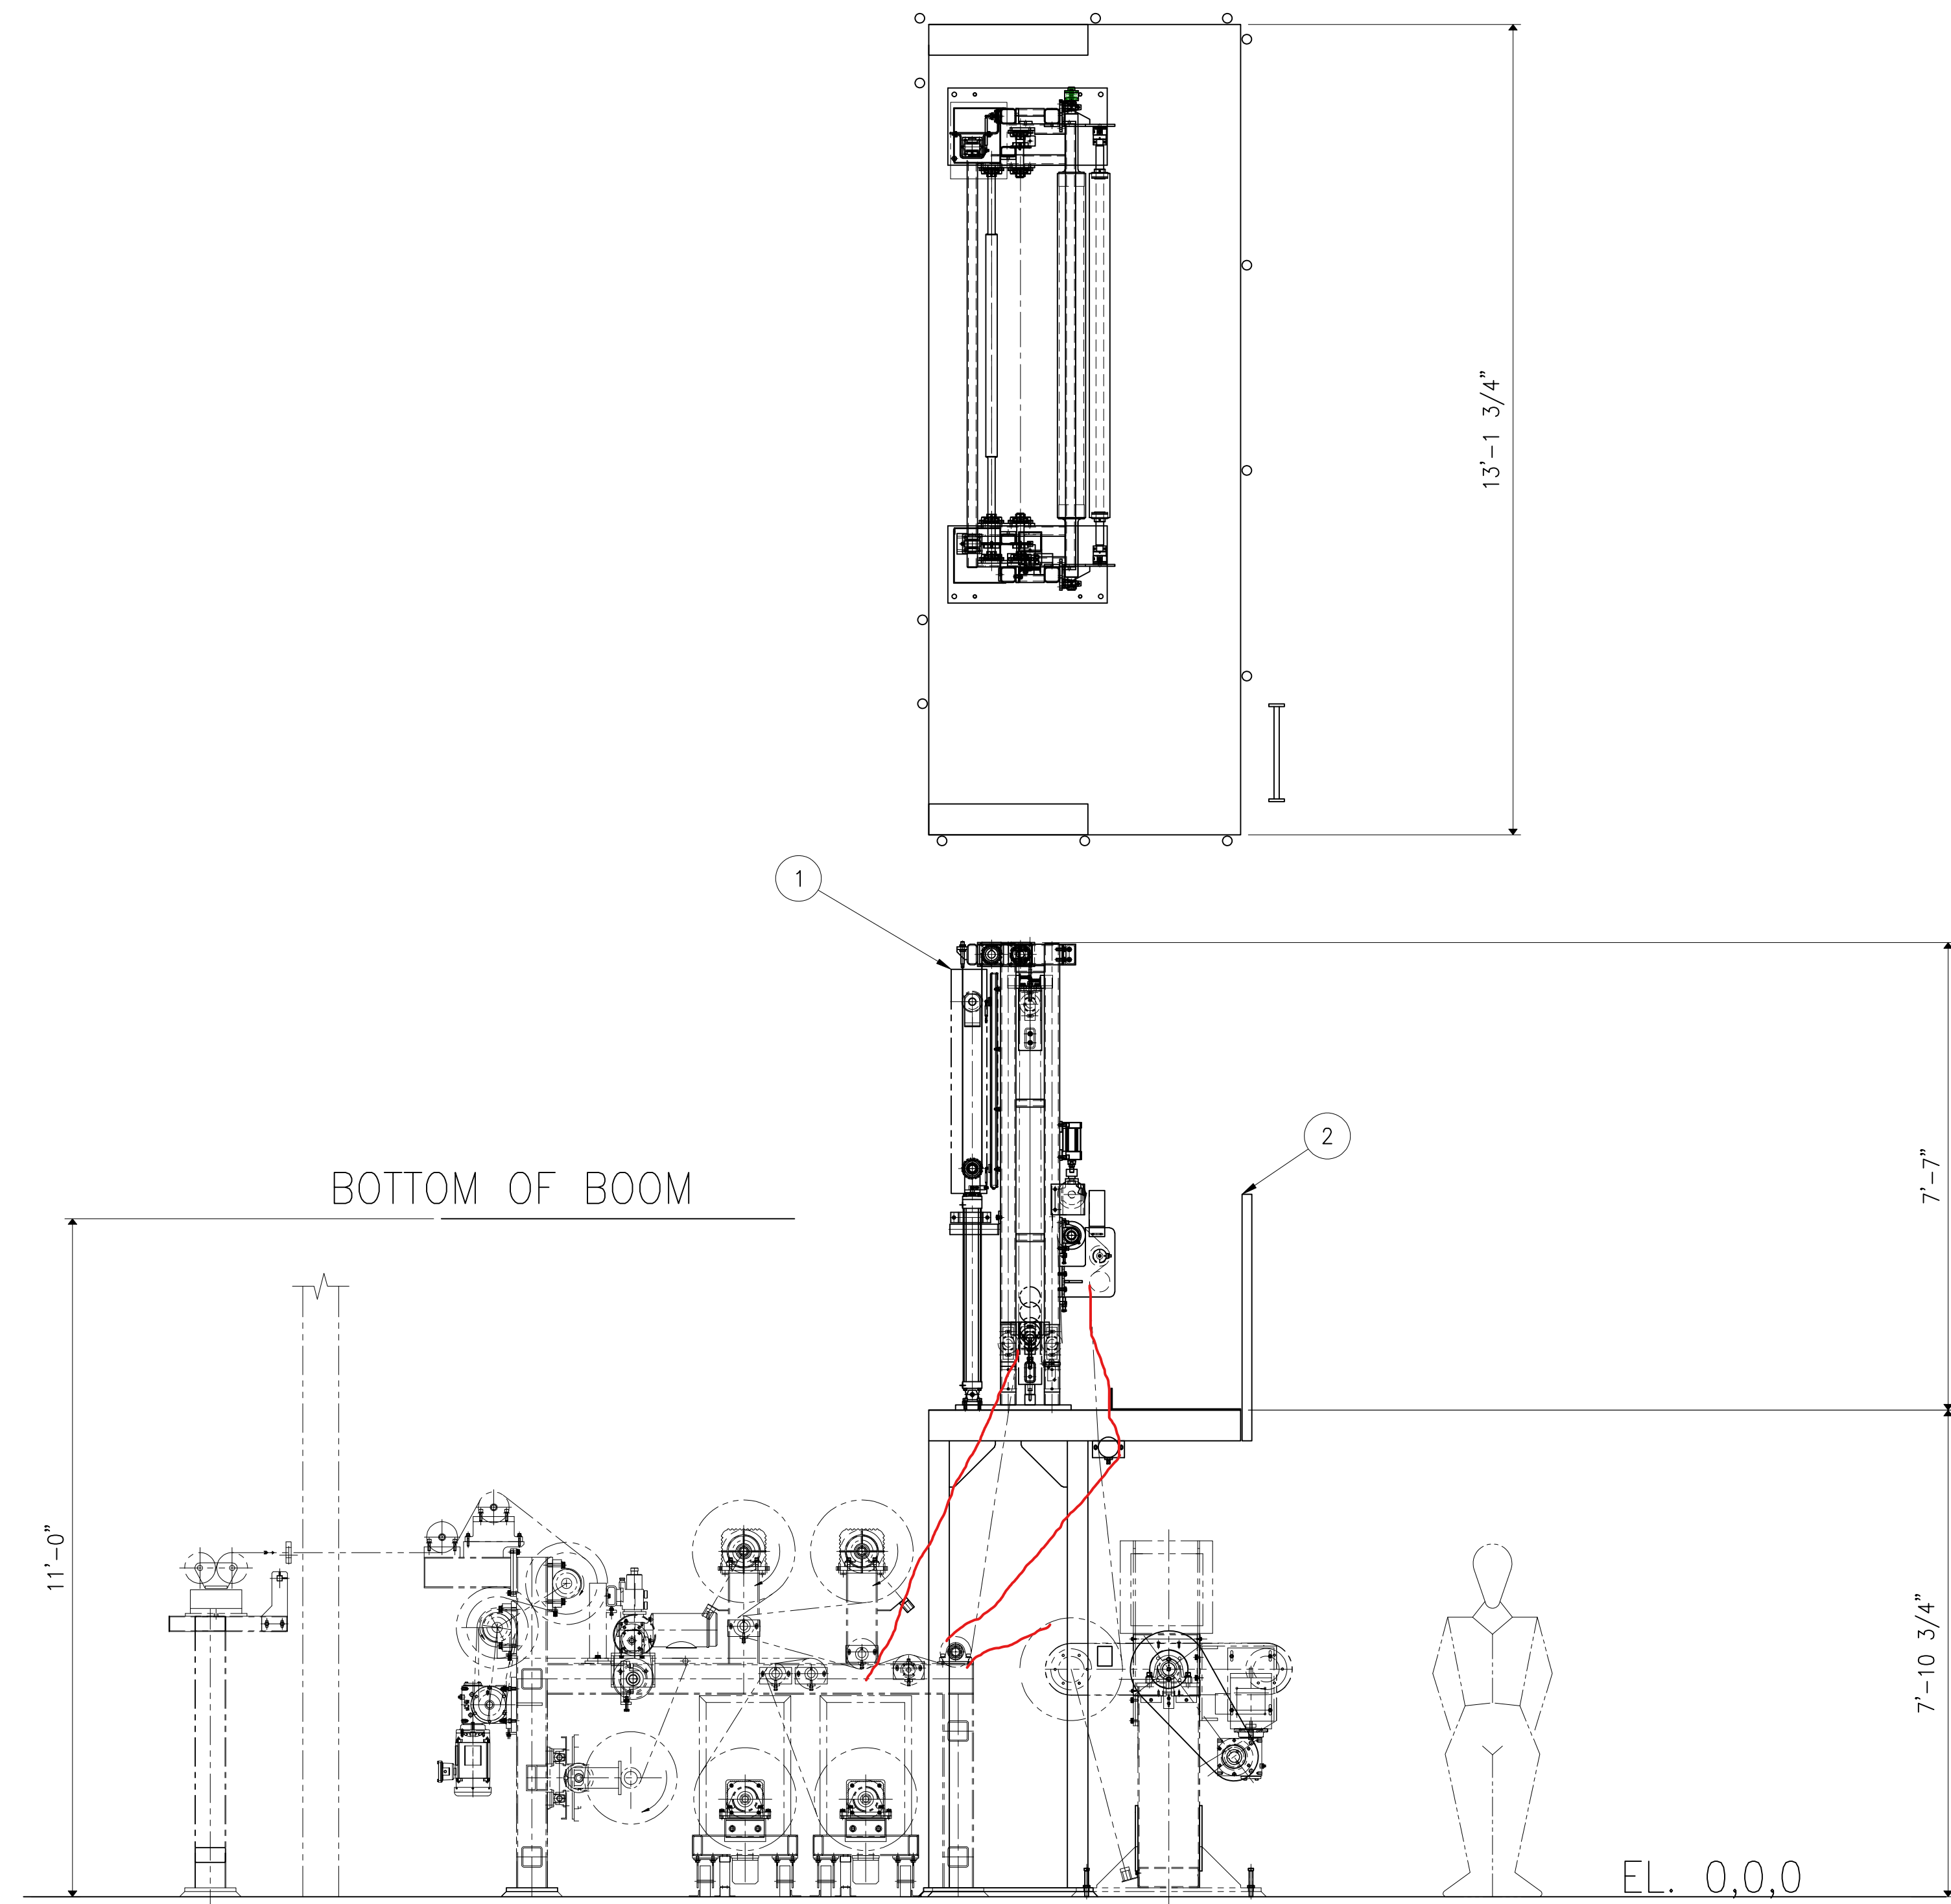


1. ACCUMULATOR AJ/AK
2. PLATFORM

REVISIONS



THIS DRAWING IS THE PROPERTY OF C. A. LITZLER CO., INC. AND IS LOANED SUBJECT TO RETURN UPON DEMAND. BORROWER AGREES THAT SAME WILL NOT BE USED IN ANY WAY DETRIMENTAL TO OWNER'S INTEREST.
C. A. LITZLER CO., INC. ASSUMES NO RESPONSIBILITY, EITHER DIRECT OR INDIRECT, FOR ANY CHANGES IN ENGINEERING DESIGN, COMPLETENESS OF DESIGN, SUBSTITUTION OF MATERIALS OR SUBSTITUTION OR ALTERATION OF COMMERCIALY SUPPLIED OR FABRICATED COMPONENTS NOT IN COMPLETE UNIFORMITY WITH IT'S DRAWINGS AND INSTRUCTIONS, UNLESS SUCH DESIGN CHANGES, DELETIONS, SUBSTITUTIONS OR ALTERATIONS ARE FIRST APPROVED BY C. A. LITZLER CO., INC. IN WRITING.

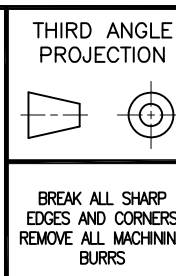

UNLESS OTHERWISE SPECIFIED	
ALL DIMENSIONS ARE EXPRESSED IN INCHES/MILLIMETERS	
ALLOWABLE VARIATIONS:	
ENGLISH UNITS	METRIC UNITS
FRACTIONS: 1/16"	NO DECIMALS: ±1.5mm
DECIMALS: .001" = ±.02"	DECIMALS: .1 = ±.5mm
ANGLES: 1/2°-30°	ON METRIC ASSEMBLY DRAWINGS ROUND DECIMAL DIMENSIONS TO THE NEAREST WHOLE MILLIMETER

DRAWING APPROVAL	
☐ APPROVED AS DRAWN	☐ APPROVED AS NOTED
NAME	DATE

C. A. LITZLER CO., INC.			
CLEVELAND, OHIO 44135-2689, U.S.A. 216-267-8020 (FAX) 216-267-9856 WEBSITE: WWW.CALITZLER.COM			
TITLE	DESIGN INFORMATION DOCUMENT	DRAWN BY	JLC 12/10/25
CHECKED BY		APPROVED BY	
FOR	WINDER ACCUMULATORS AJ/AK	APPROVED BY	

JOB NUMBER: 2058	SECTION: 98.24
SCALE: 1/2"=1'-0"	DWG. NO. DID2058 01 A
TOTAL DRAWING SHEETS 3	SHT. REV.

REF. DWG.